

SUFFOLK COUNTY DEPARTMENT OF PUBLIC WORKS

Division of Bridges, Structures and Waterways


By K. SWARINGEN, G. Kelsey

Sheet No. 1 OF 1


Checked By ..... MILL RD CULVERT GEOMETRY

Date 9/22/16 4/2/18

42-0138: 2/97og

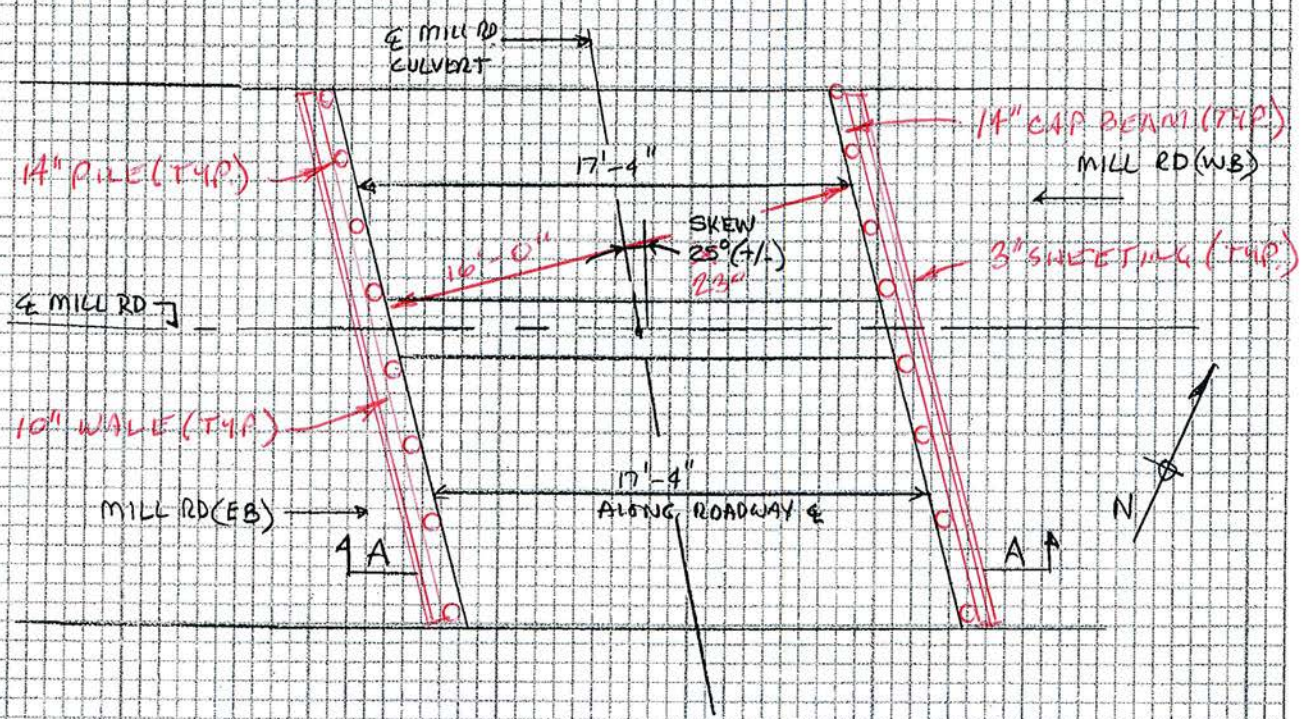

PLAN VIEW (MILL RD CULVERT)  
(N.T.S.)

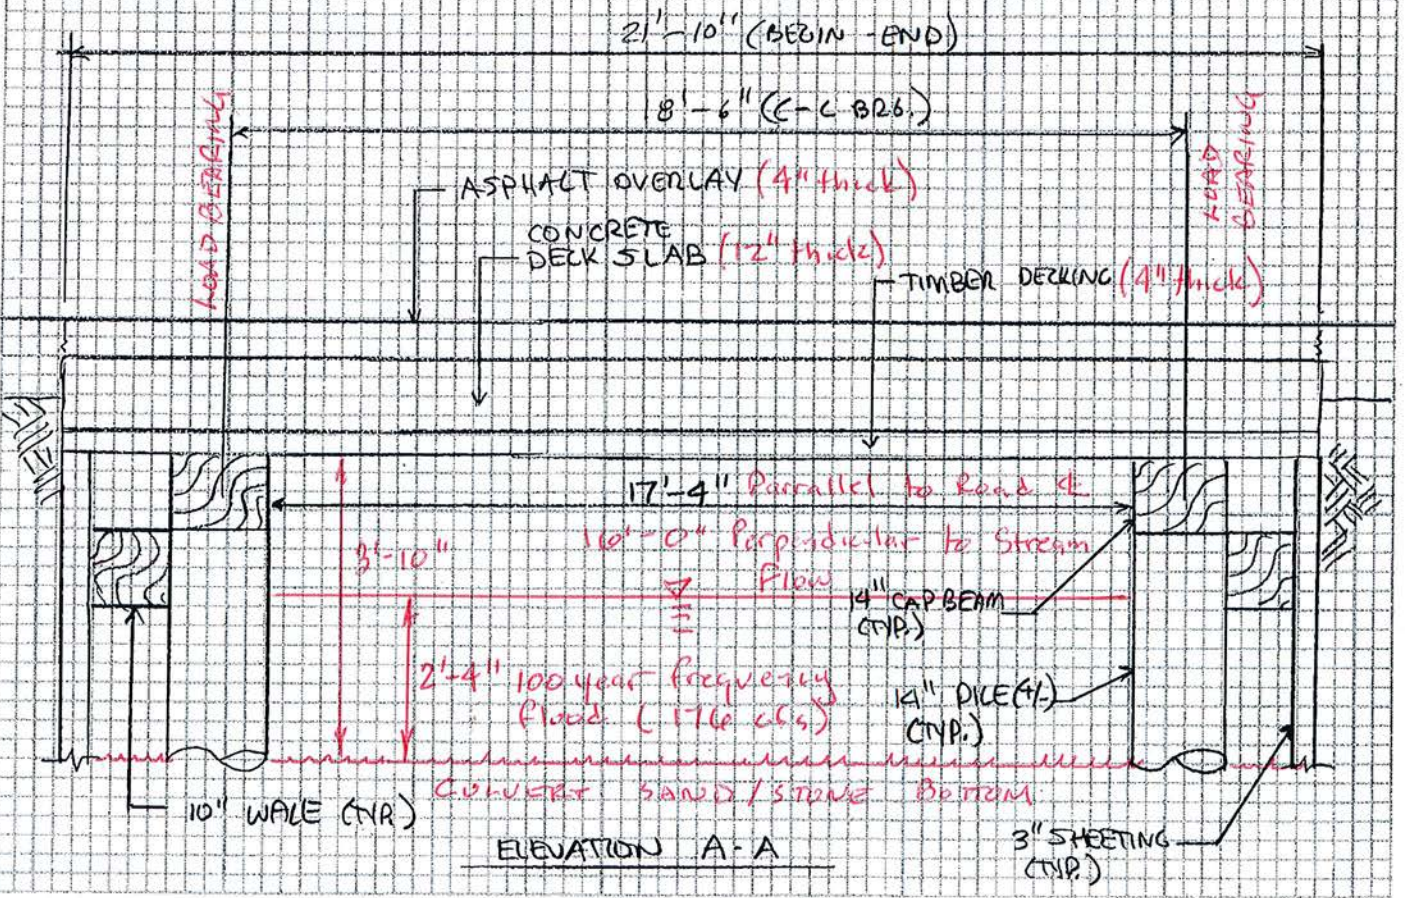

ELEVATION A-A